



NORTH ELEVATION (FRONT)


- ELEVATION NOTES: (ALL WINDOWS/DOORS INSET 2" W/ DARK BRONZE ALUM. U.O.N. W/ #5 TRIM U.O.N.)
1. TUDOR STYLE (ROUGH FINISH - (SEE SHEAR WALL SCHEDULE) - 3 COAT STUCCO APPLICATION PER 2501.1.
 2. EL Dorado - FIELD LEDGE "MESETA" STONE.
 3. 6" G.I. GUTTER O/ 2 X 12 FASCIA. (KELLY MOORE OW-25)
 4. MISSION STYLE ROOF TILES LT. WEIGHT CONC. TILE (MONIER LIFETILE, VILLA CASA GRANDE BLEND CT IVACS 6169 ESR-1647) ROOFING, OVER 30# FELT UNDERLAYMENT, MIN. CLASS "A".
 5. FAUXCRETE TRIM. (KELLY MOORE #73).
 6. BLACK IRON RAILINGS & ARCHWAY.
 7. STUCCO ARCHADE W. ROCK BASE
 8. RUFSAWN 4X WOOD DOORS
 9. BLACK IRON GRILLE WORK
 10. 20X20 NICHE (INSET 3/4") ARCHED W/ #5.
 11. 4 X 12 CUT / SHAPED DECORATIVE BEAM (MATCH #8).
 12. 24" PLASTER DECORATIVE
 13. 2030 WINDOW & TRIM (ARCHED #5)
 14. 5050 / 1/2 DIA. WINDOW W/ TRIM #5.
 15. 80100 NICHE (INSET 3/4") W/ #5.
 16. DECORATIVE FOAM PLANT - ON GRILL W/ #5.
 17. 4040 WINDOW NICHED W/ SPANDREL GLASS W/ #5.
 18. BLACK IRON RAILINGS
 19. 5050 WINDOW W/ TRIM #5.
 20. 3030 WINDOW W/ TRIM #5.
 21. 4050 WINDOW
 22. 4010 WINDOW W/ GLASS & TRIM #5.
 23. 4015 WINDOW W/ ARCH WINDOW ABOVE W/ TRIM #5.
 24. 5050 NICHE W/ ARCH (INSET 3/4") W/ 2X2 BLACK IRON LATTICE W/ #5.
 25. NICHE DOOR W/ BLACK IRON GRILL W/ #5.
 26. WROUGHT IRON PLANT ON.
 27. 24" FAUX CRETE COL. (KELLY MOORE OW-25)
 28. 80100 ARCH OPNG. W/ #5.
 29. 4040 WINDOWS W/ #5.
 30. 4040 NICHE (INSET 3/4") W/ #5.
 31. 4050 ARCH NICHE (INSET 3/4") W/ #5.
 32. 24" WIDE VALLEY FLASH 26 GA. GSM.

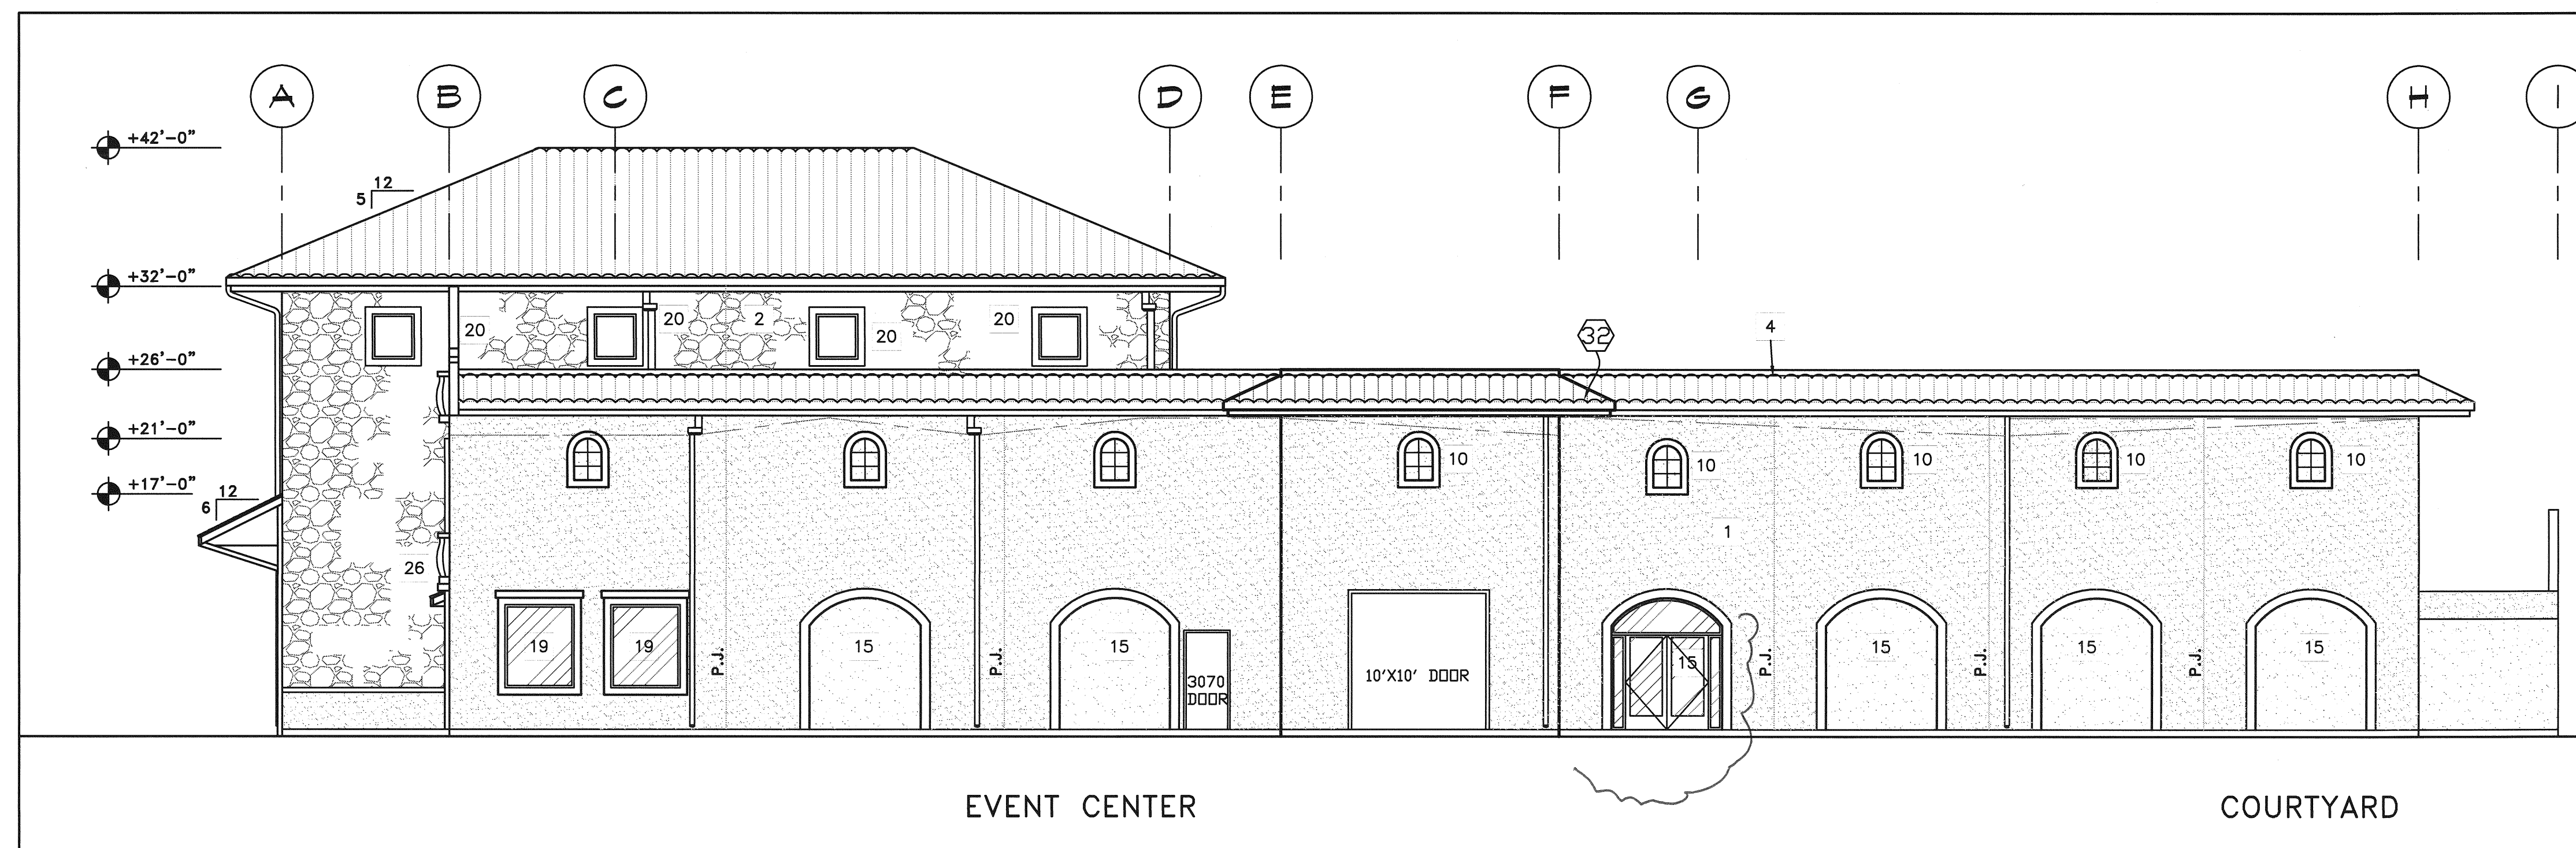


WEST ELEVATION (SIDE EVENT CENTER)

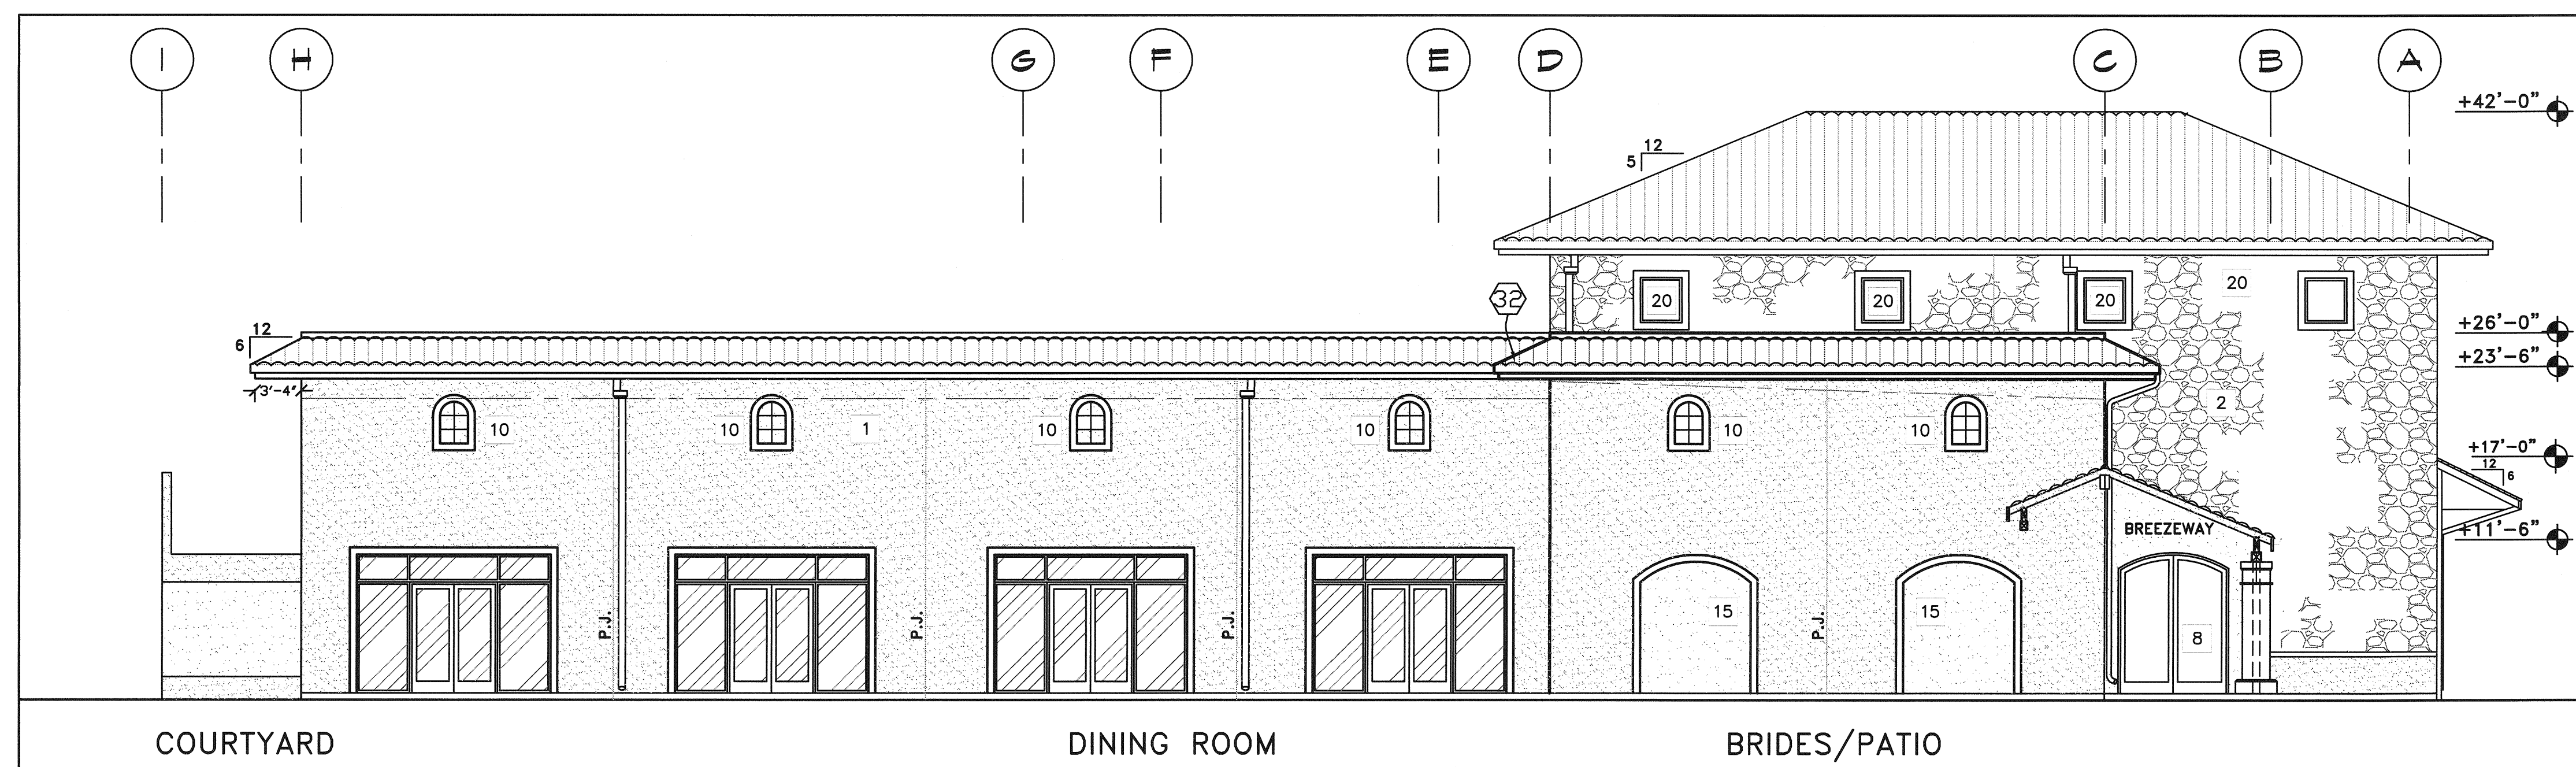

EAST ELEVATION (SIDE EVENT CENTER, COURTYARD)

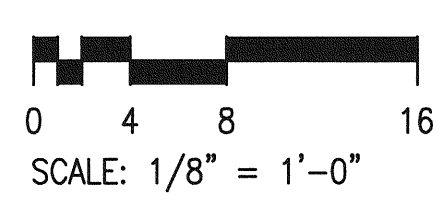

REVISIONS	NO.
PLAN CHECK 5-2-07	1

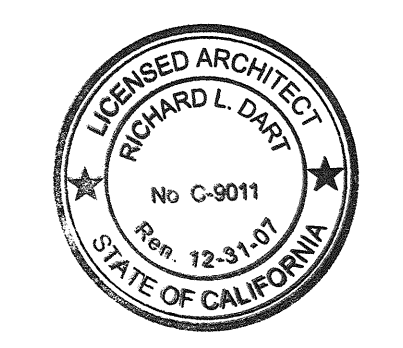

Richard L. Dart Architect, Inc.
 849 E. STANLEY BLVD. #212
 LIVERMORE, CA 94550 925-449-3884

EXTERIOR ELEV

RUBY HILL EVENT CENTER
 AND WINERY

444 VINEYARD AVE., PLEASANTON, CA 94566

DRAWN	IA
CHECKED	RD
DATE	5-2-07
SCALE	1/8" = 1'-0"
JOB	
SHEET	A3.1